


EXISTING SITE PLAN  
1/8" = 1'-0"

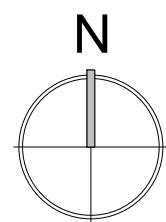


AS-BUILT  
100 MARKET STREET  
SAN FRANCISCO, CA

SITE



DATE: 02/05/24  
SCALE: 1/8" = 1'-0"  
DRAWN: Author  
JOB No: 2401

X 1.0

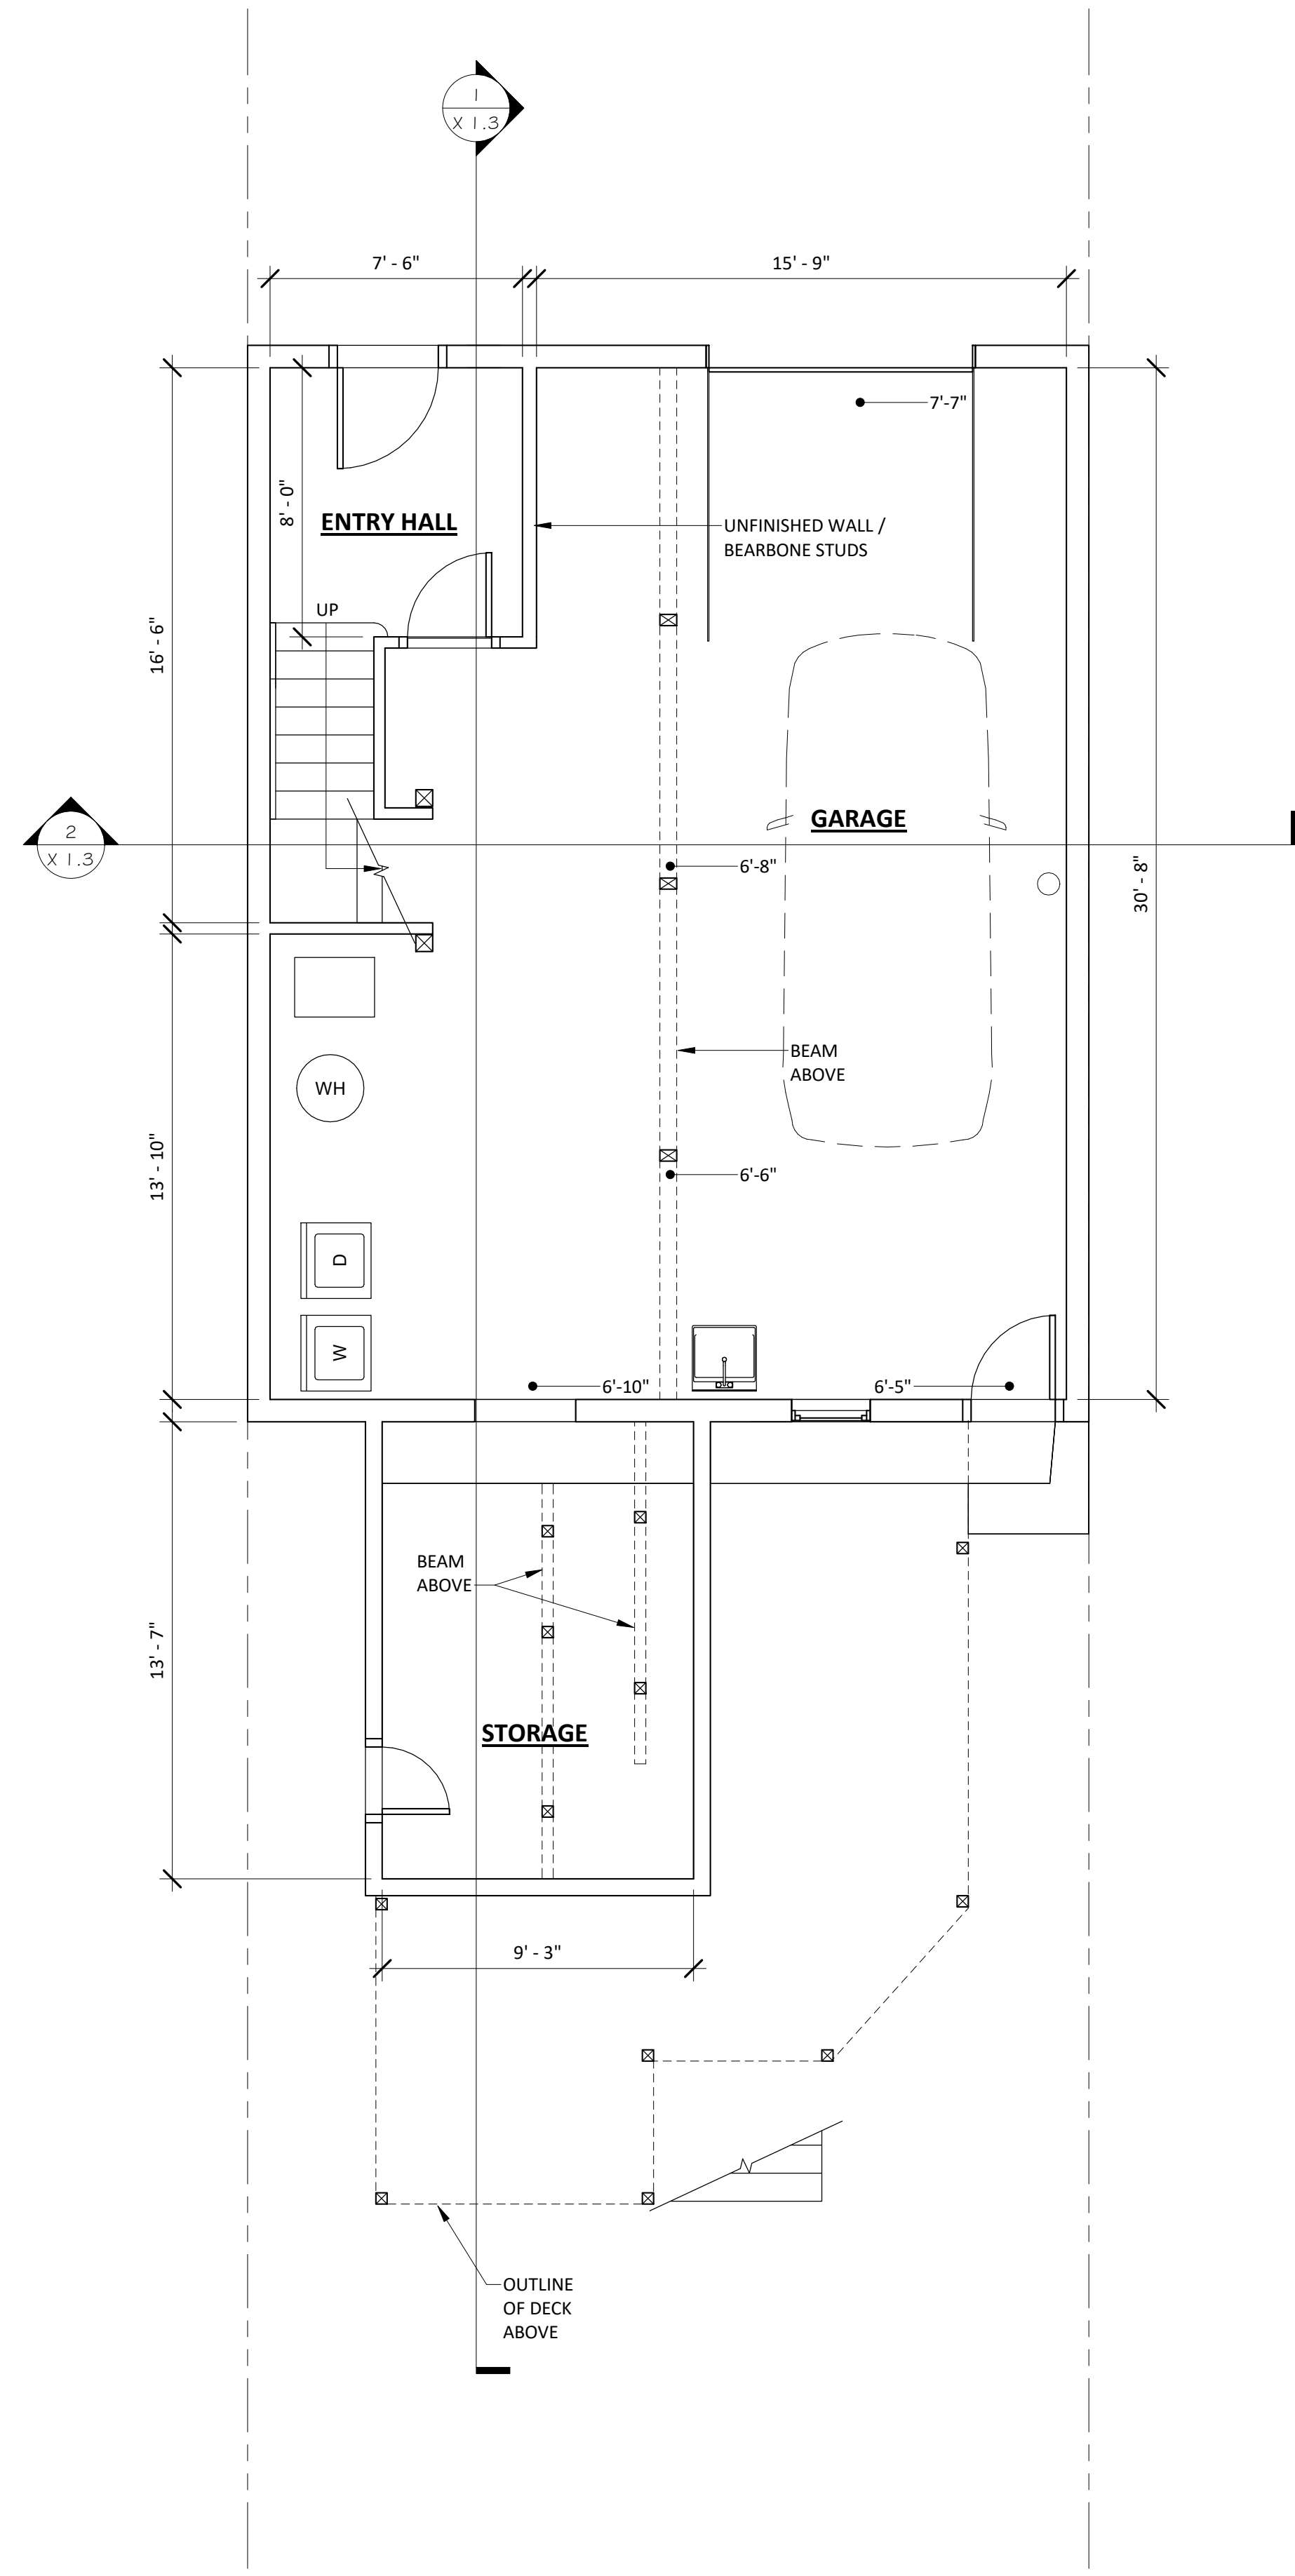



EXISTING PLAN - 1ST FLOOR

1/4" = 1'-0"

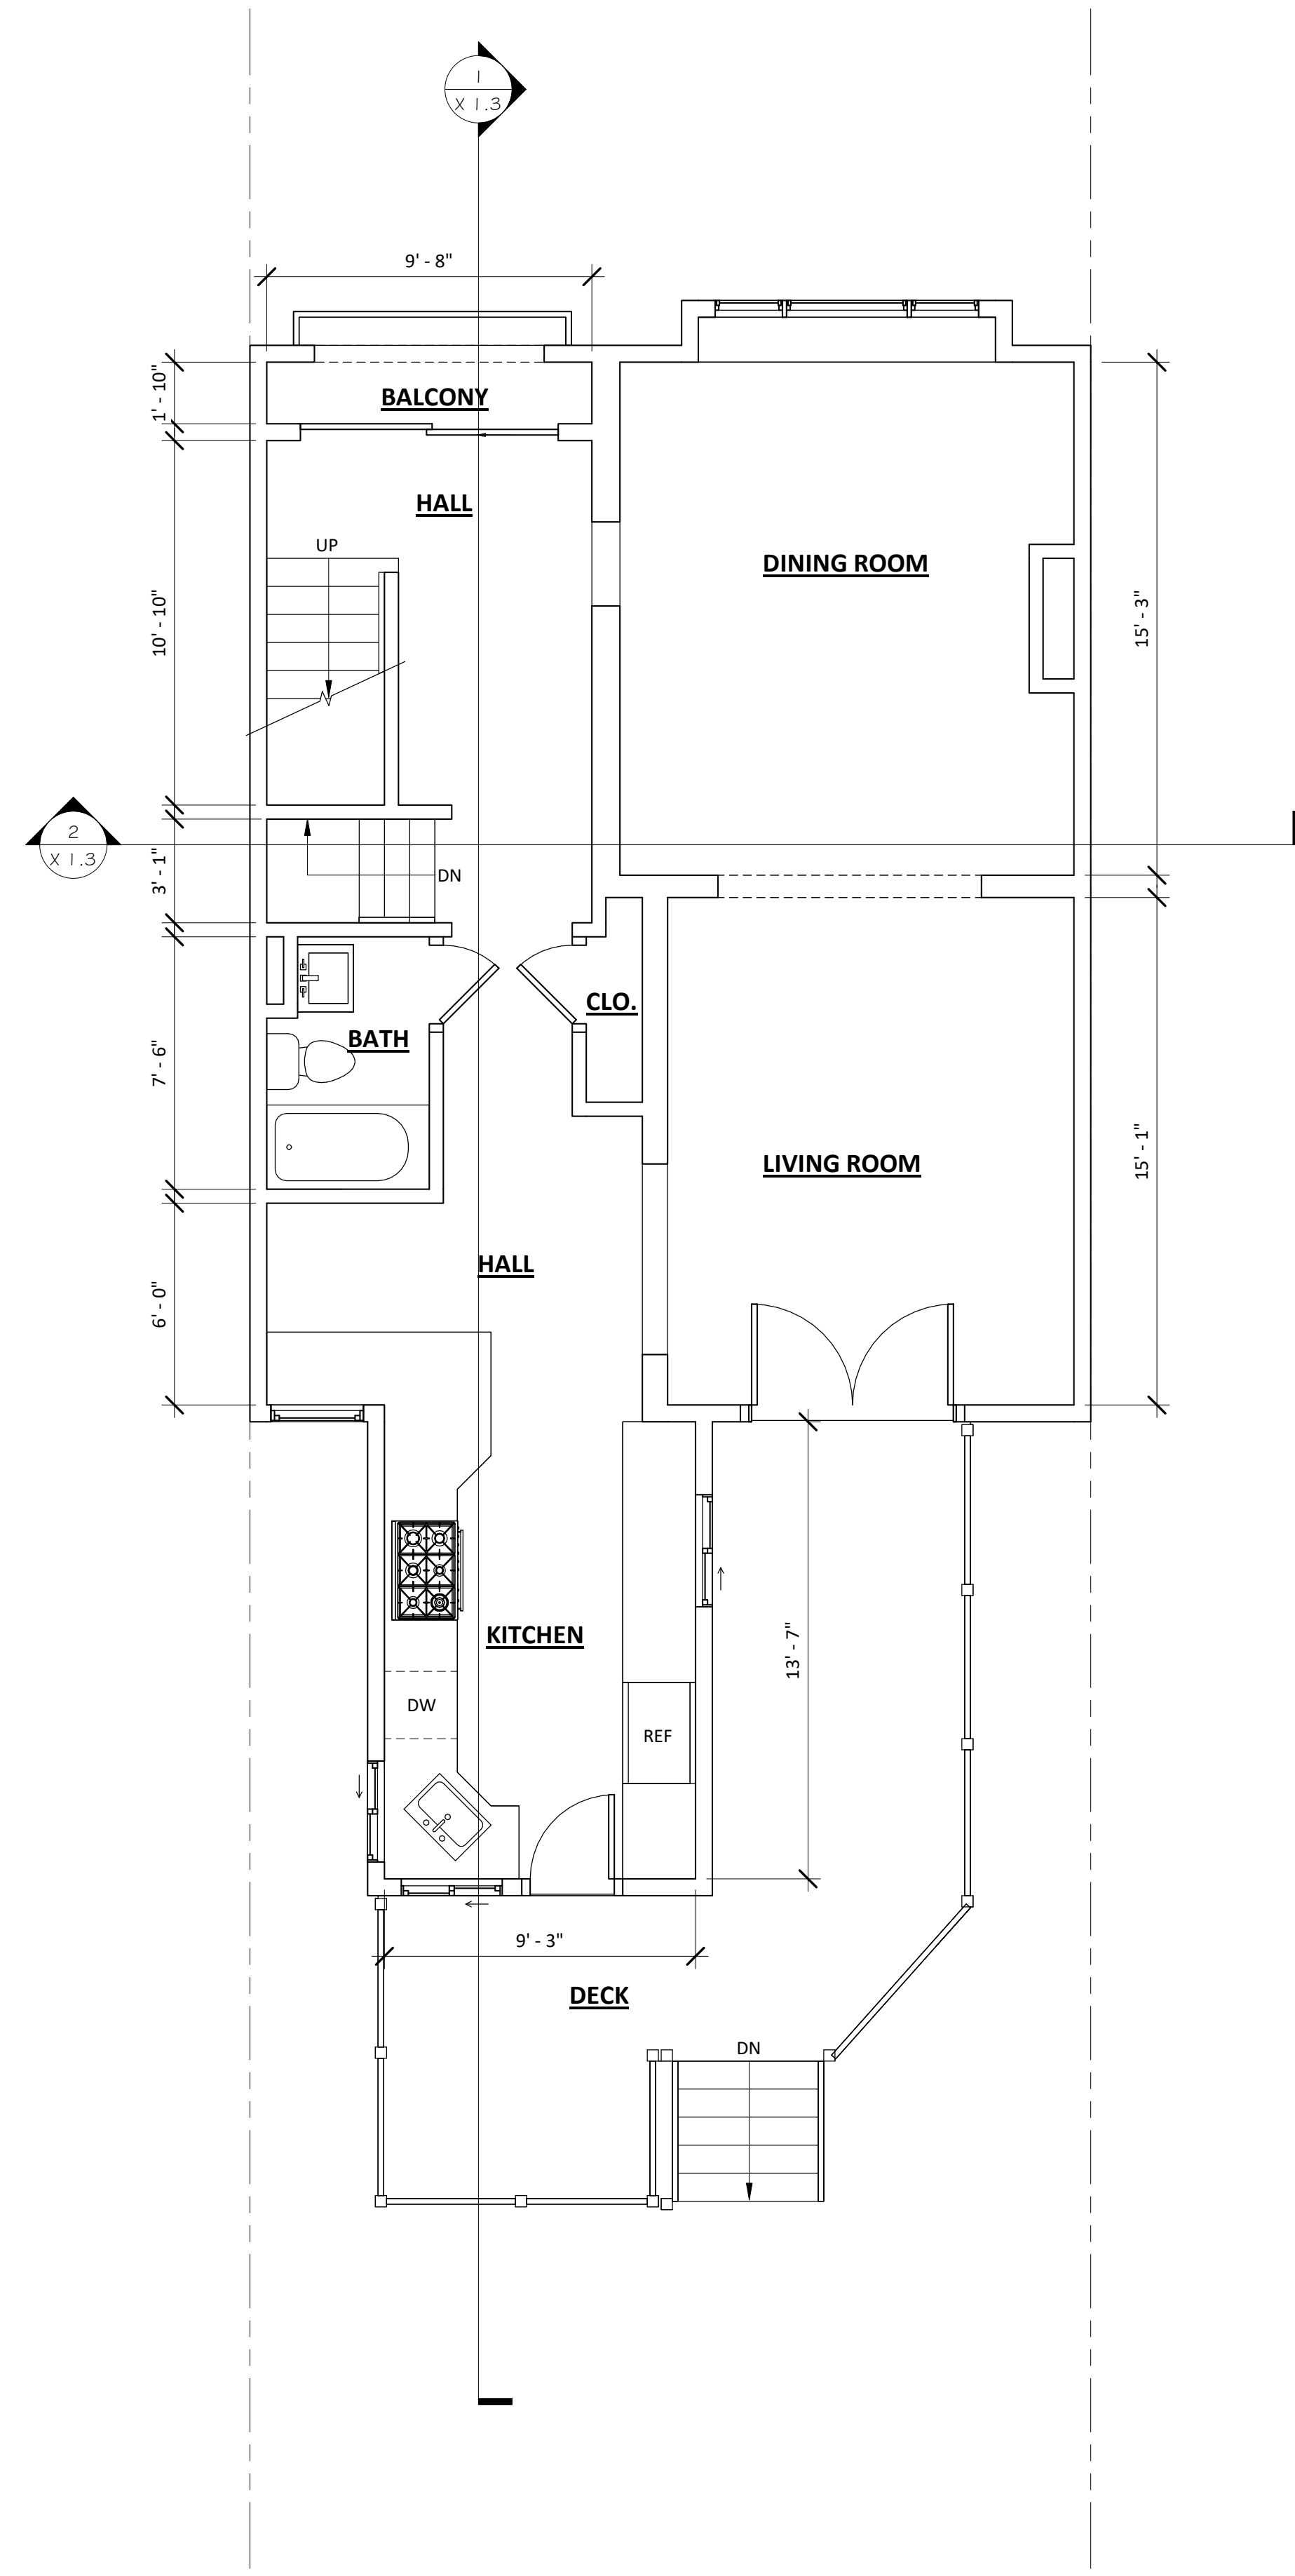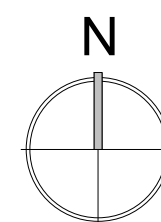


EXISTING PLAN - 2ND FLOOR

1/4" = 1'-0"

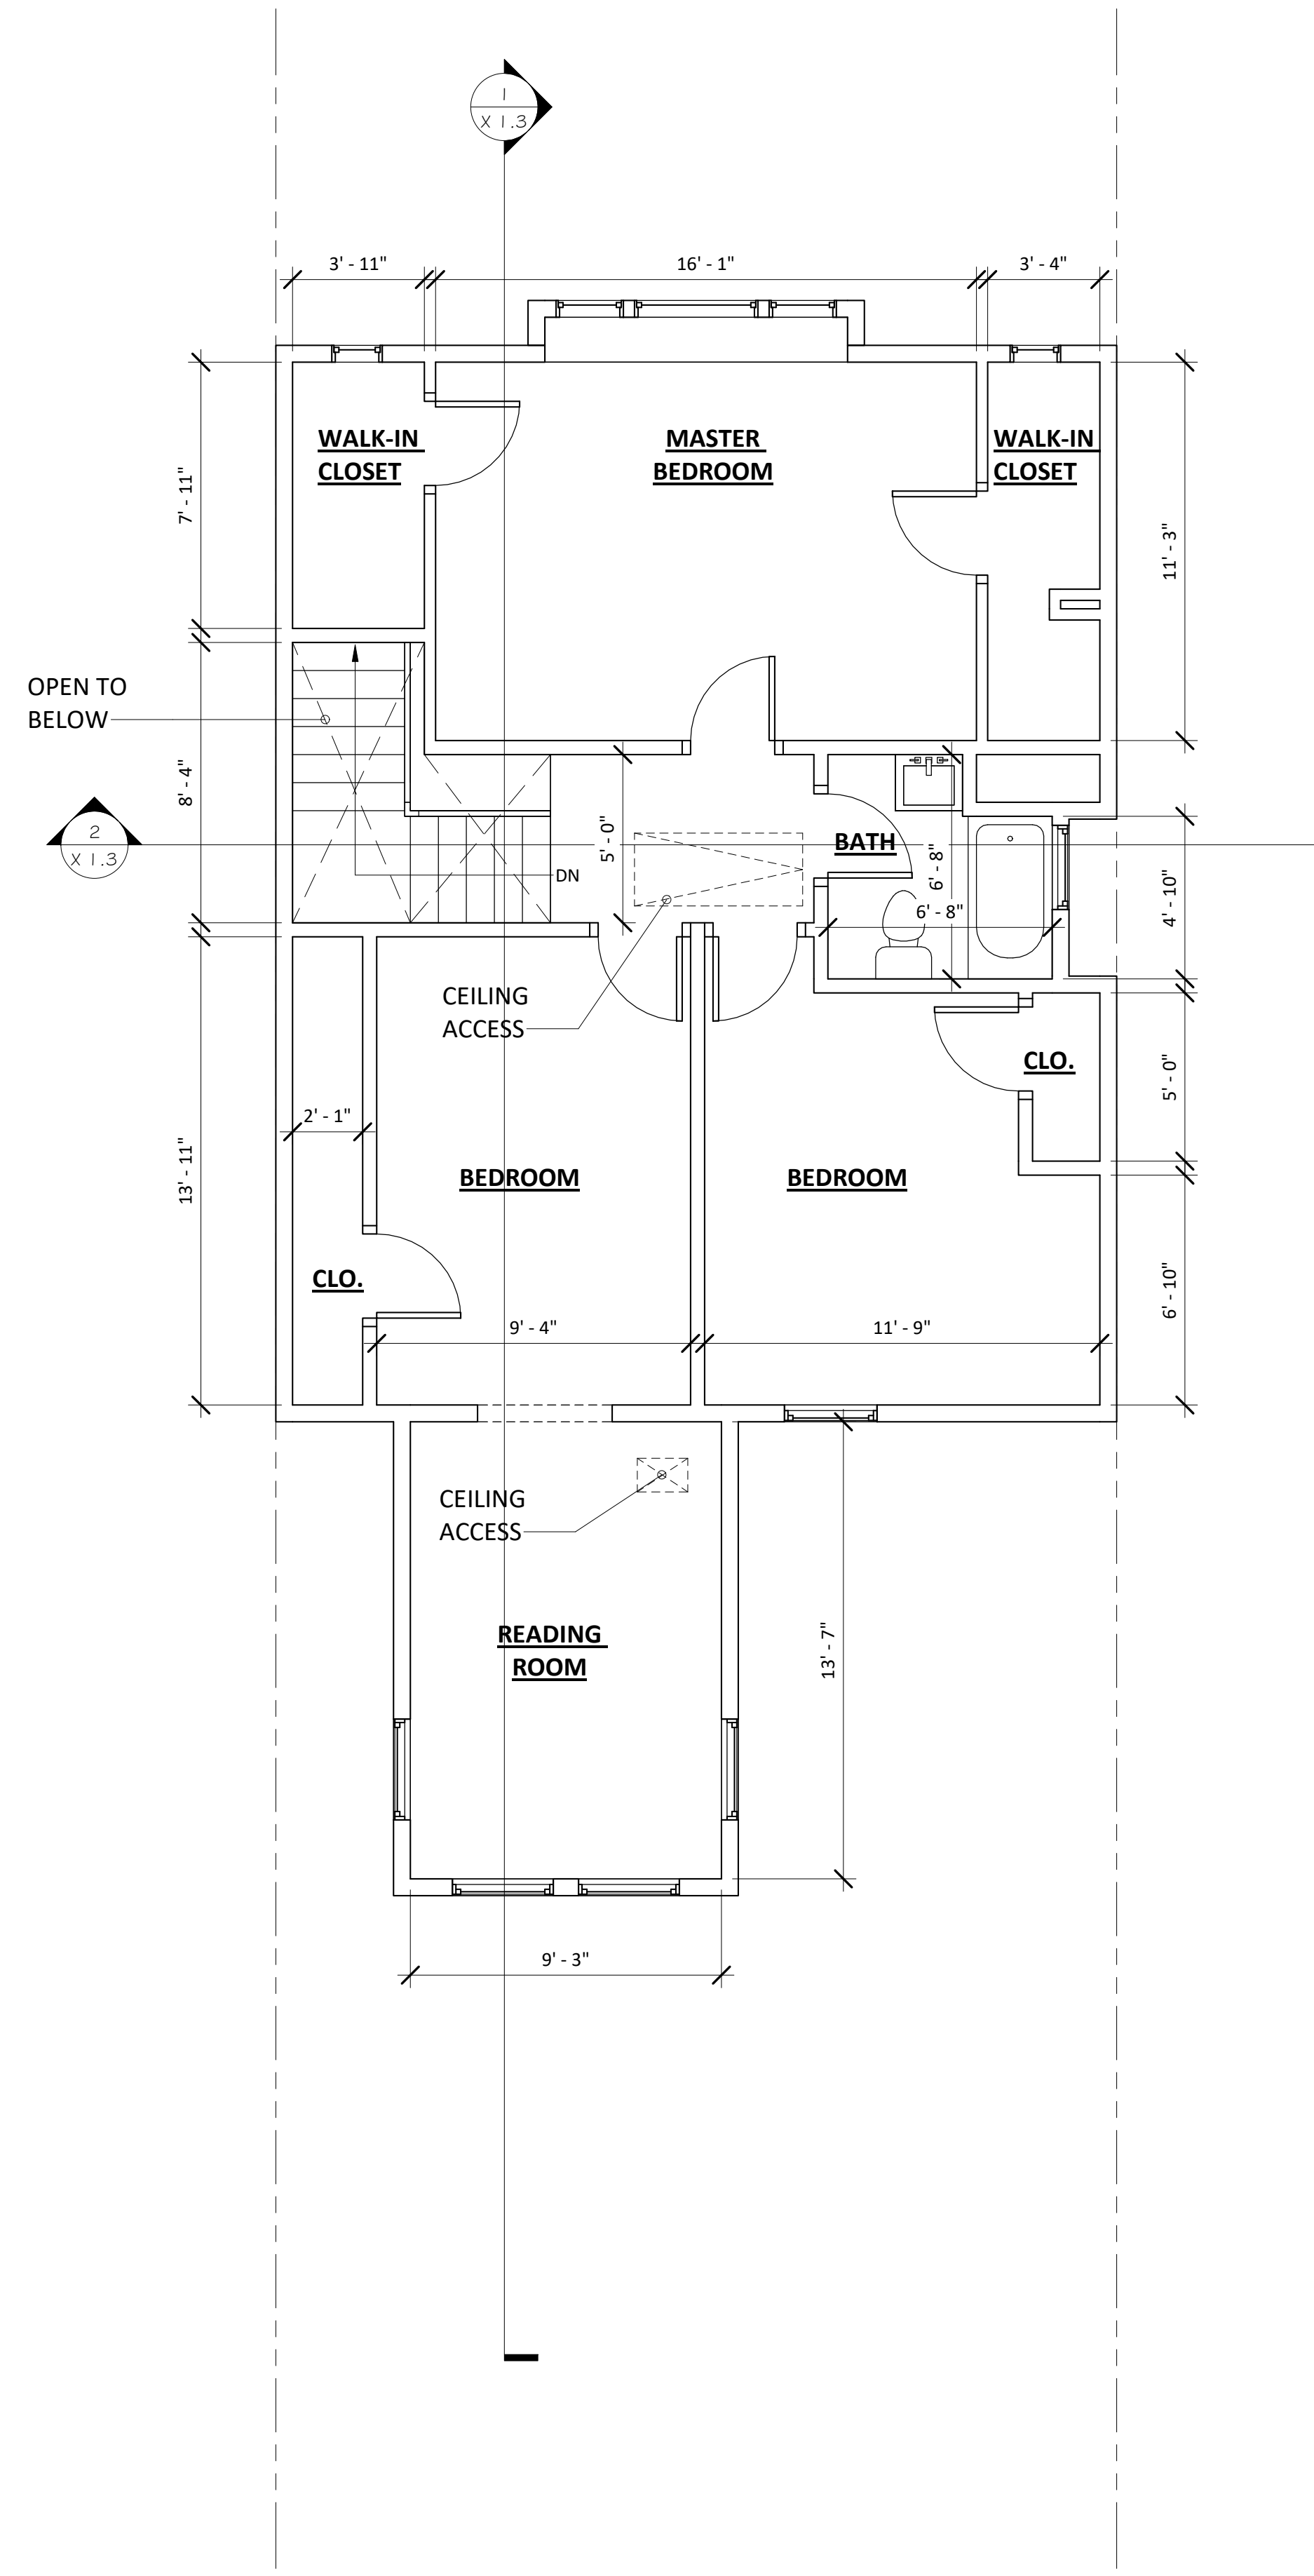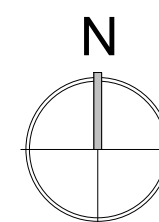

EXISTING PLAN - 3RD FLOOR

1/4" = 1'-0"

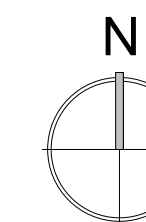


AS-BUILT  
100 MARKET STREET  
SAN FRANCISCO, CA

FLOOR PLAN


DATE: 02/05/24  
SCALE: 1/4" = 1'-0"  
DRAWN: AA  
JOB No: 2401

X 1.1

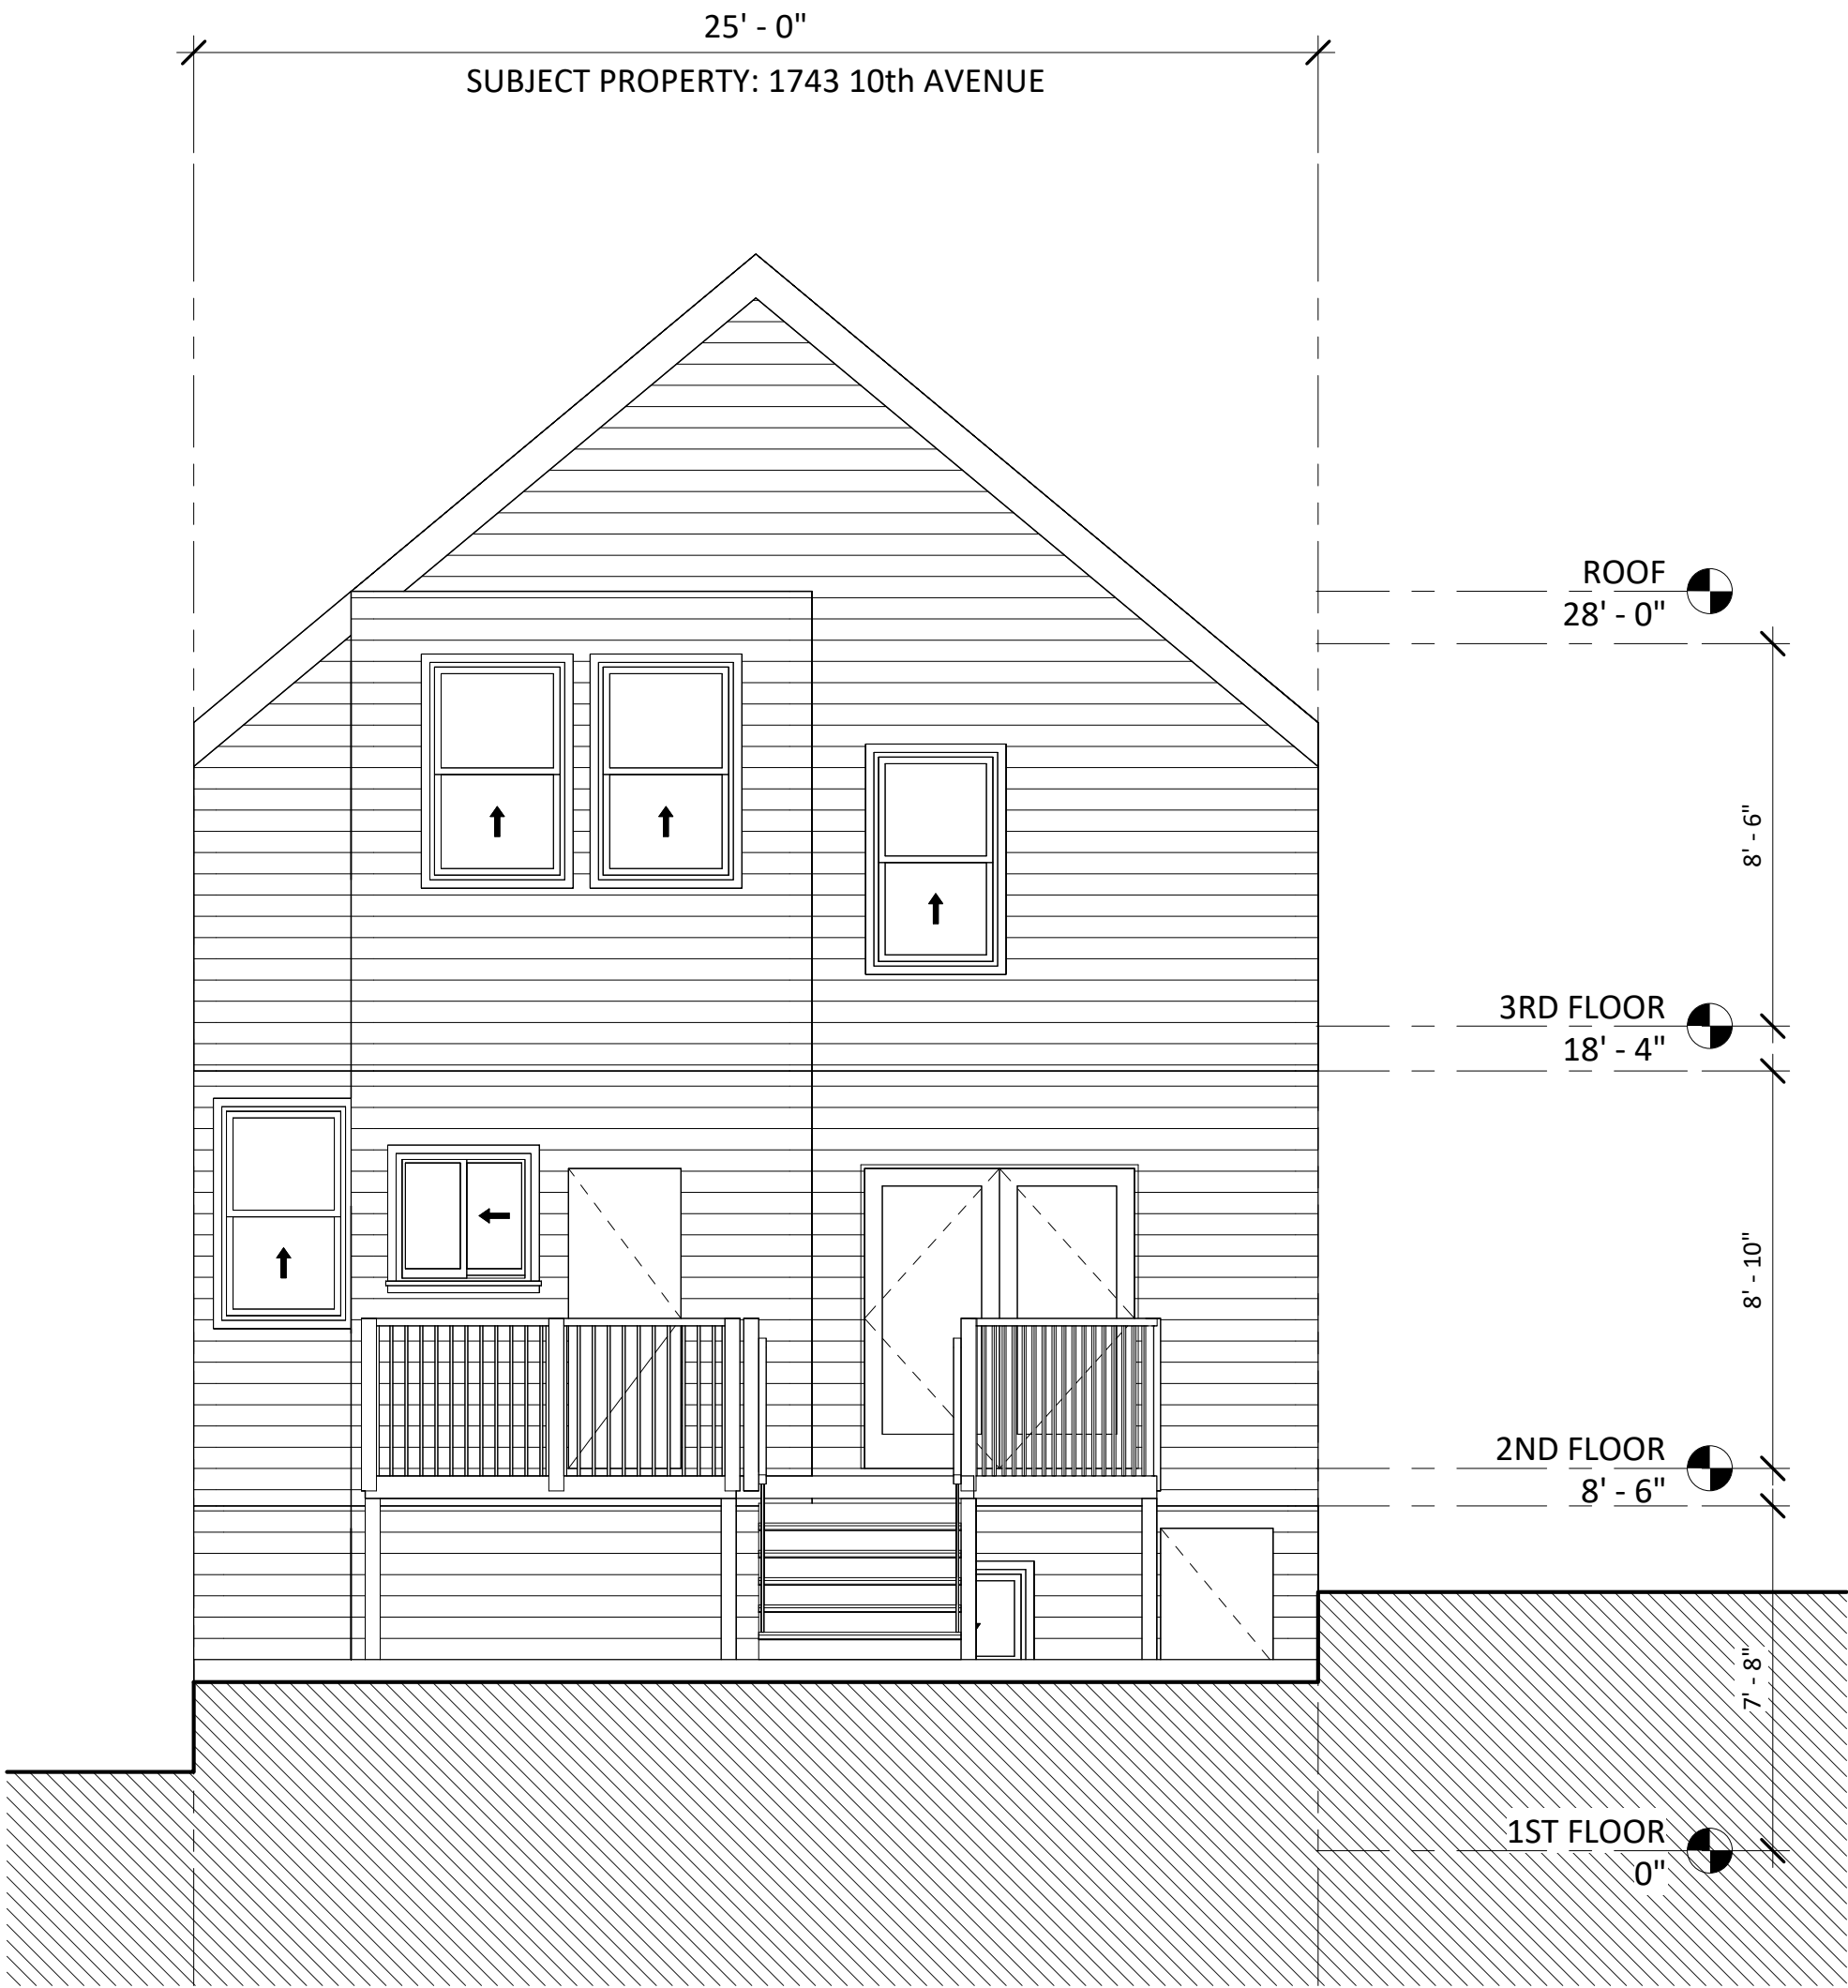

EXISTING REAR ELEVATION - WEST

1/4" = 1'-0"

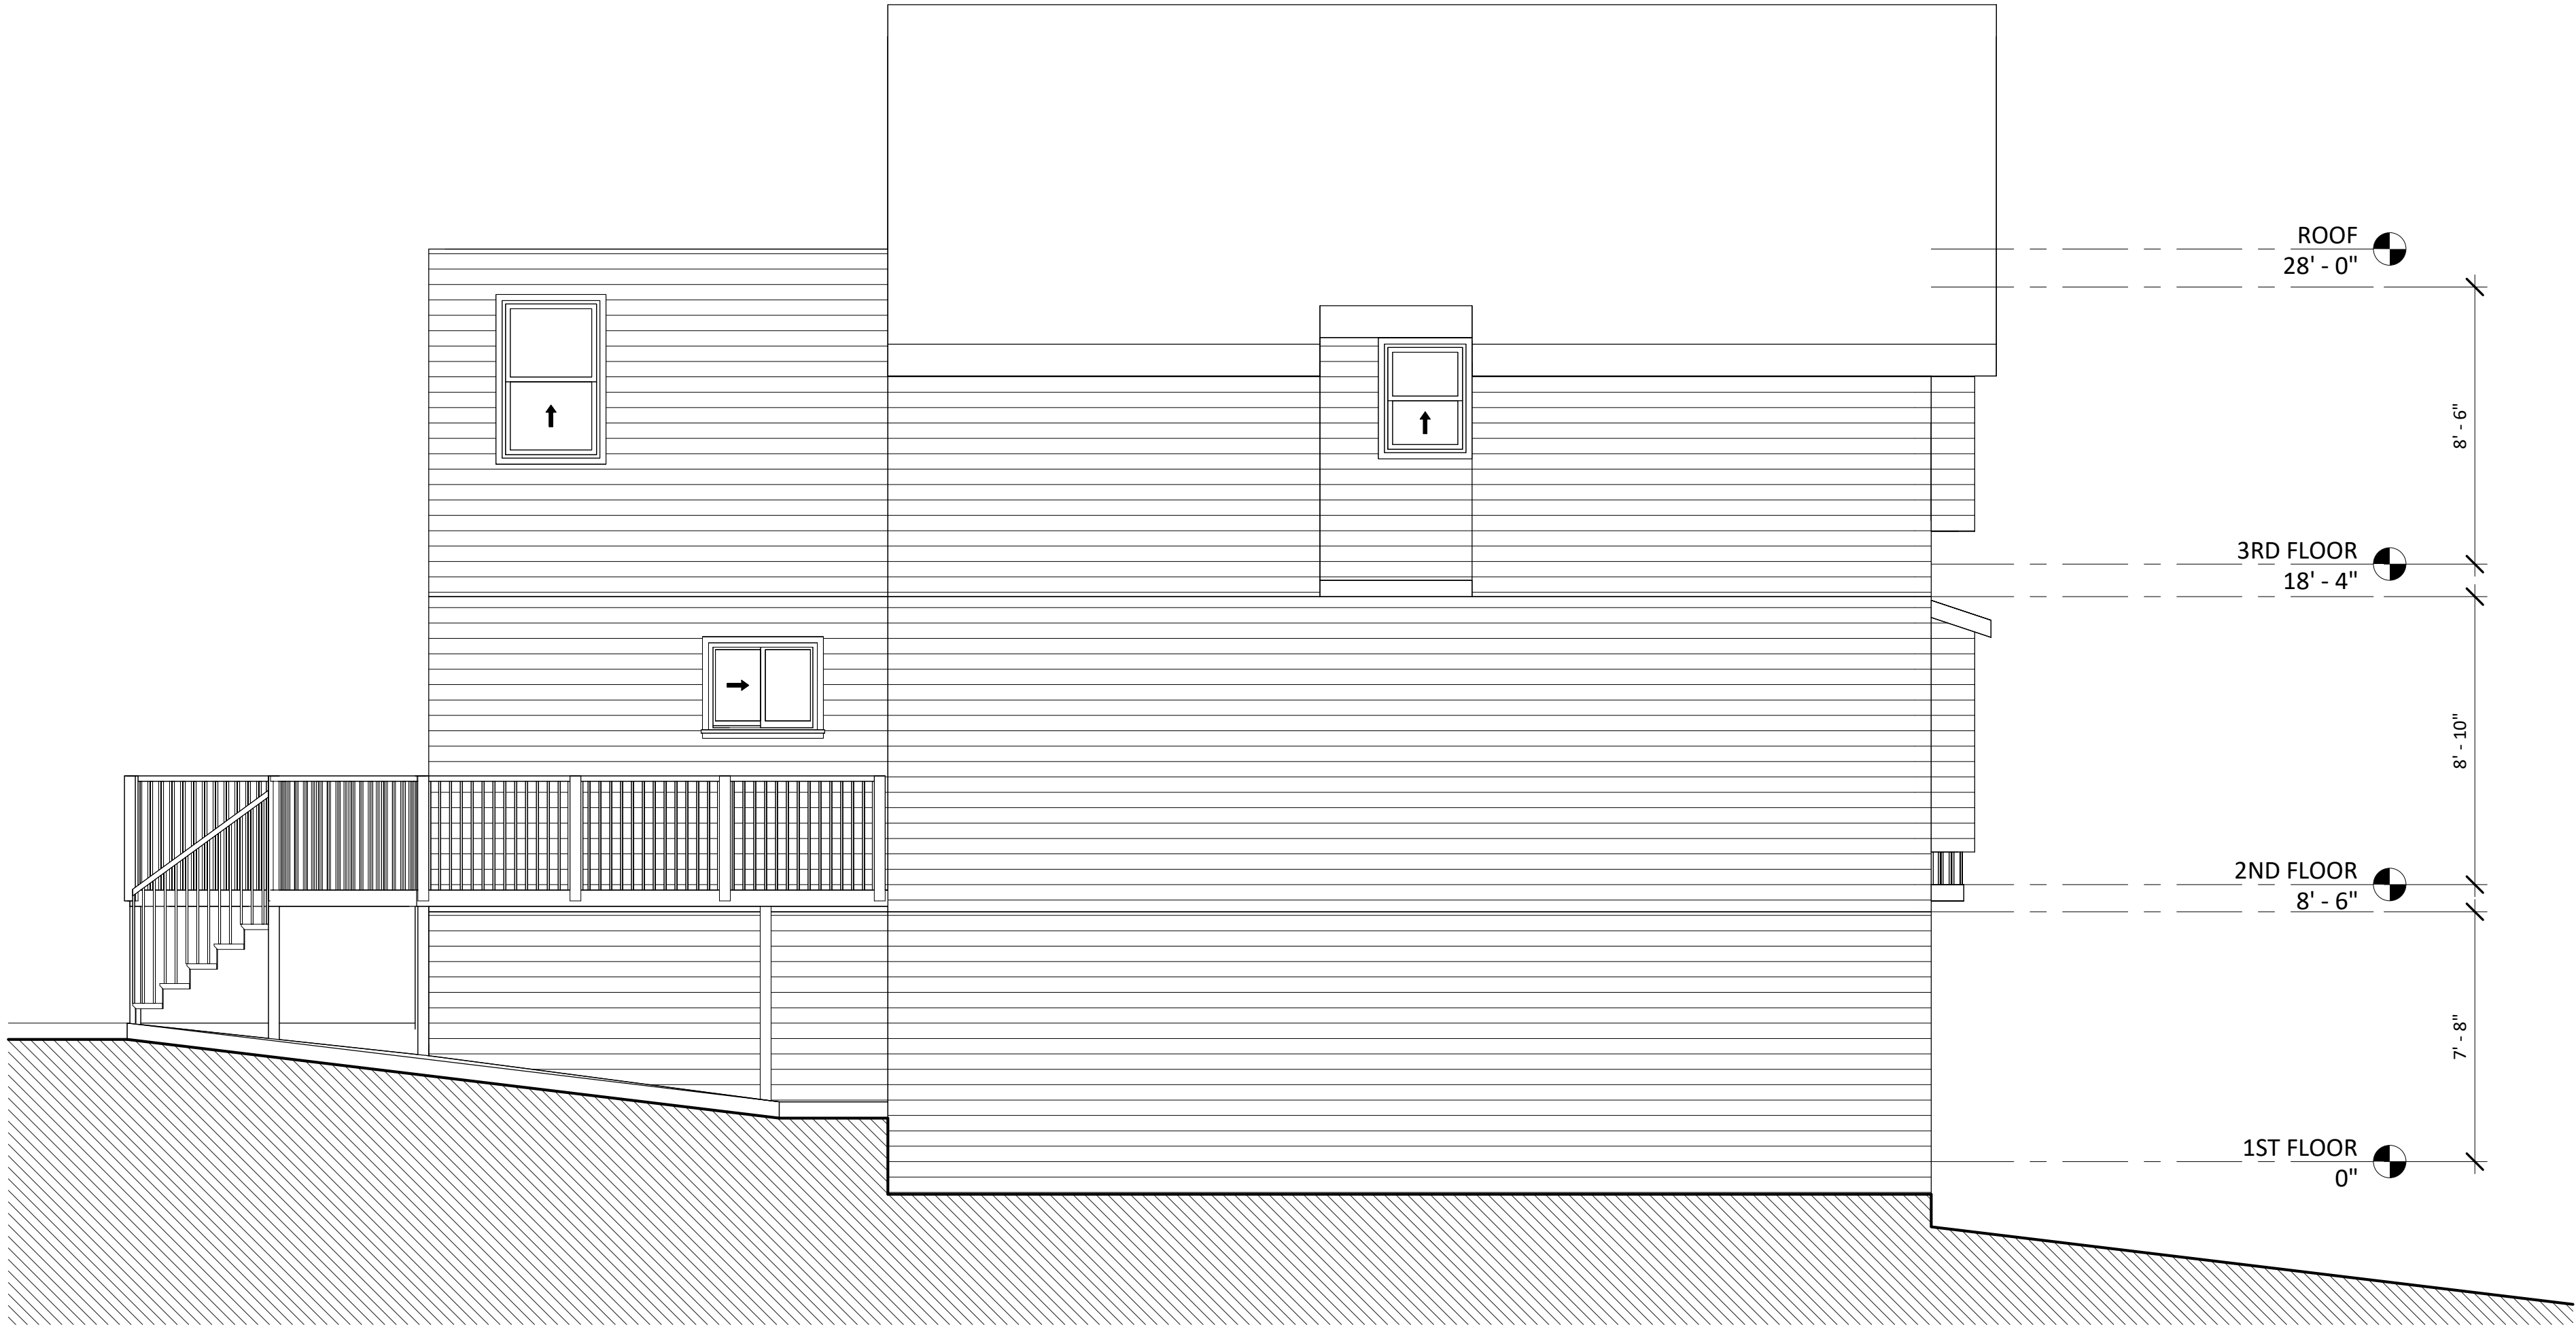

EXISTING SIDE ELEVATION - SOUTH

1/4" = 1'-0"

AS-BUILT  
100 MARKET STREET  
SAN FRANCISCO, CA


ELEVATION

DATE: 02/05/24  
SCALE: 1/4" = 1'-0"  
DRAWN: Author  
JOB No: 2401

X 1.2



1  
EXISTING SECTION  
1/4" = 1'-0"

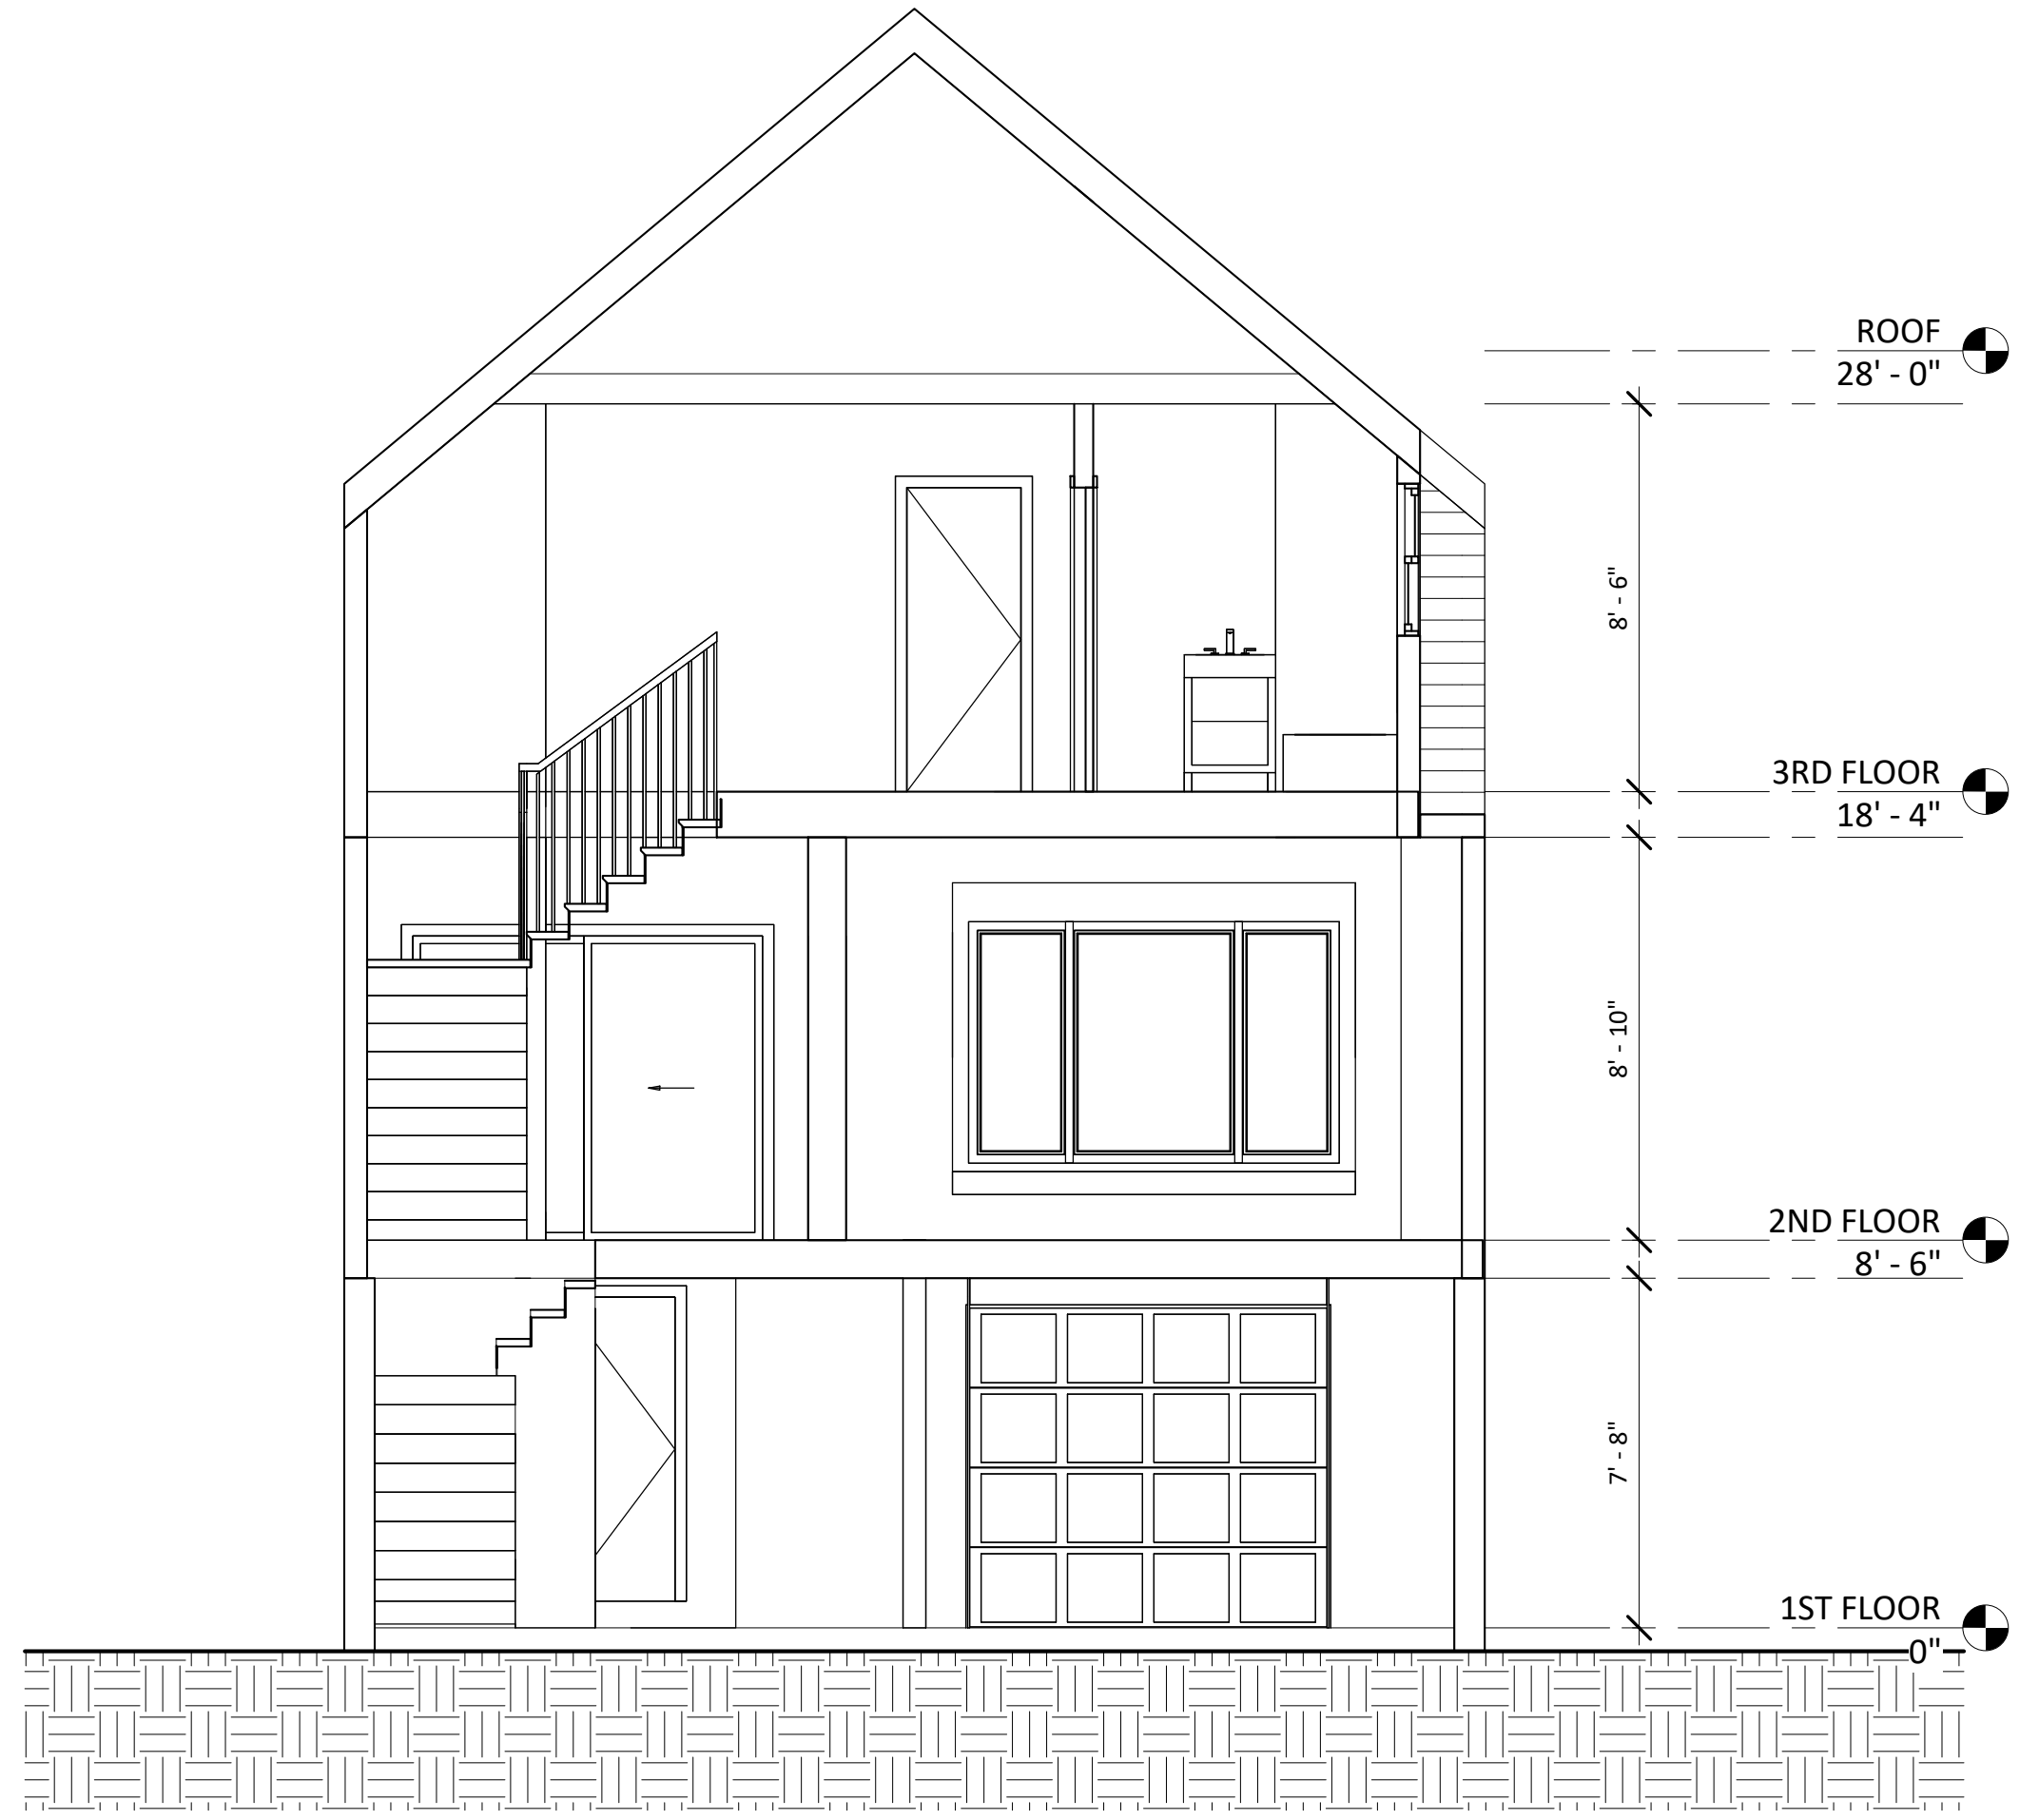

2  
EXISTING SECTION  
1/4" = 1'-0"

AS-BUILT  
100 MARKET STREET  
SAN FRANCISCO, CA

SECTIONS

DATE: 02/05/24  
SCALE: 1/4" = 1'-0"  
DRAWN: Author  
JOB No: 2401

X 1.3